PAY QUANTITIES (BASE BID) UNIT QUANTITY AS-BUILT ITEM# ITEM SUPERPAVE, TYPE S5 (PG 70-28) TON 170 C.Y. TYPE A AGGREGATE 740 TACK COAT GAL. 665 (14)(15) EA. MANHOLE (6' DIAMETER) \36" x 23" R.C. ARCH PIPE _ (14) L.F. ິ 350∕ົ 44" x 27" R.C. ARCH PIPE (14) L.F. 1350 (14) L.F. 12" RCP 120 15" RCP (14) | L.F. 24 18" RCP 24 REMOVAL OF STRUCTURES AND OBSTRUCTIONS (04)(05)(14) LSUM REMOVAL OF ASPHALT PAVEMENT (5) S.Y. 1313 3405 12. SAWING PAVEMENT L.F. (5) (14) L.F. REMOVAL OF 12" STORM DRAIN PIPE 120 REMOVAL OF 15" STORM DRAIN PIPE (5) (14) L.F. 24 **REMOVAL OF 18" STORM DRAIN PIPE** (5) (14) L.F. 1750 REMOVAL OF 30" STORM DRAIN PIPE (5) (14) L.F. 40 REMOVAL OF MANHOLE 17 (5) (14) EA. (5) (14) L.F. 175 REMOVAL OF CURB & GUTTER TRAFFIC STRIPE (THERMOPLASTIC)(24" WHITE) 432 L.F. 20. TRAFFIC STRIPE (THERMOPLASTIC)(4" YELLOW) L.F. 2765 TRAFFIC STRIPE (THERMOPLASTIC)(6" WHITE) L.F. 710 21. EA. 22. TRAFFIC STRIPE (ARROW) 2 TRAFFIC STRIPE (WORD) EA.

(10) S.D.

(10) S.D.

(10) S.D.

(10) L.F.

(10) S.D.

(3) EA.

(13) TON

(12) LSUM

(9) S.Y.

(6)|LSUM

(3) LSUM

(3) L.F.

(14) L.F.

(5) | S.Y.

(7)(8)| EA.

(17)| C.Y |

(14)(15) EA.

(14) (15) EA.

(11) EA.

LSUM

LSUM

EA.

(16) S.Y. 1400

L.F.

(1)(2)(3) S.Y.

5040

1200

1200

125

15000

50

250

175

165

43

20

50

24.

25.

29.

31.

33.

37.

41.

DRUMS

TYPE III BARRICADE

3" SURGE ROCK

DEWATERING

MOBILIZATION

LEAKAGE TESTING

EROSION BARRIER

43. 8" SANITARY SEWER PIPE

4' DIAMETER MANHOLE

P.C. CONCRETE (3500 PSI)

MANHOLE (8' DIAMETER)

18" SOLID SLAB SODDING

INLET PROTECTION DEVICES

6" BARRIER CURB AND GUTTER

6" CONCRETE DRIVEWAY (HES)

DOGHOUSE MANHOLE (4' DIAMETER)

REMOVAL OF CONCRETE DRIVEWAY

CONSTRUCTION STAKING

CONSTRUCTION SIGNS 6.26 SF TO 15.99 SF

DELIVER PORTABLE LONGITUDINAL BARRIER

SWPPP DOCUMENTATION AND MANAGEMENT

1" SERVICE LINE REMOVAL AND REPLACEMENT

8" CONCRETE UTILITY TRENCH REPAIR (HES)

(PL) REMOVE AND RESET EXISTING SIGNS

(PL) PORTABLE LONGITUDINAL BARRIER DELINEATOR

REMOVAL AND REPLACEMENT OF CHANNEL RETAINING WALL (5) LSUM

	PAY QUANTITIES (ADD ALTERNATE 1)			
ITEM#	ITEM	UNIT	QUANTITY	AS-BUILT
	ADD ALTERNATE 1	<u> </u>	V V	V
<u></u>	2" MILL OF ASPHALT PAVEMENT (5) (18)	S.Y.	7557	
2.	SUPERPAVE, TYPE S5 (2" OVERLAY) (18)	TON	850	
			^ ^	

UTILITY CONTACTS					
UTILITY PROVIDER	CONTACT NAME	PHONE NUMBER			
OKLAHOMA NATURAL GAS	DEREK ROPER	405-556-6459			
INDIAN NATIONS FIBER OPTIC	EDDIE TOMLINSON	520-522-3837			
OG&E	RAE ANNE LAWRENCE	405-553-5785			
COX COMMUNICATIONS	MARK BOWLING	405-417-4064			

GENERAL NOTES

SEE STANDARD SPECIFICATIONS FOR MAINTENANCE OF LOCAL AND THROUGH TRAFFIC.

FOR PROJECTS THAT INCLUDE WIDENING AND/OR RESURFACING, THE CONTRACTOR SHALL SCHEDULE OPERATIONS TO MINIMIZE POTENTIAL DROP—OFF HAZARDS AND SHALL SUBMIT A SEQUENCE OF ANY PORTION OF THE CONSTRUCTION OPERATIONS TO THE RESIDENT ENGINEER FOR APPROVAL BEFORE OPERATIONS BEGIN. ANY PORTION OF THE CONSTRUCTION OPERATIONS, SUCH AS SUPERPAVE LAYING OPERATIONS, EXCAVATION FOR PAVEMENT WIDENING, OR EXTENSION OF ROADWAY STRUCTURES, SHALL BE LIMITED TO ONE SIDE AT A TIME, AND THE PROCEDURES OUTLINED IN THE PAVEMENT DROP=OFF TREATMENT STANDARD PDT—1—(LATEST REVISION) SHALL BE IMPLEMENTED. ONLY THAT AMOUNT OF OPEN TRENCH WILL BE ALLOWED THAT CAN BE SURFACED IN 1 (ONE) DAY'S TIME WITHOUT APPROVAL BY THE ENGINEER. LIGHTS, SIGNS AND BARRICADES SHALL BE MOVED AS WORK PROGRESSES.

ALL TREES, BRUSH, AND OTHER DEBRIS THAT MIGHT INTERFERE WITH THE FLOW OF WATER SHALL BE CLEANED OUT TO THE RIGHT-OF-WAY LINE, AT EACH STRUCTURE AND BRIDGE, IN A MANNER APPROVED BY THE ENGINEER. ALL COSTS TO BE INCLUDED IN OTHER ITEMS OF WORK.

ALL FLOWLINES THAT ARE TO BE FILLED SHALL BE THOROUGHLY TAMPED BEFORE CONSTRUCTION OR EXTENSION OF DRAINAGE STRUCTURES. ALL COSTS TO BE INCLUDED IN OTHER ITEMS OF WORK.

IN ORDER TO ALLEVIATE DUST CONDITIONS DURING GRADING OPERATIONS AND BEFORE PAVEMENT WORK IS COMPLETED, THE CONTRACTOR SHALL SPRINKLE GRADING AT INTERVALS APPROVED BY THE ENGINEER. ALL COSTS TO BE INCLUDED IN OTHER ITEMS OF WORK.

THE CONTRACTOR SHALL NOT WASTE ANY EXCESS EXCAVATION UNTIL ALL PLANNED EMBANKMENTS AND BACKFILLS ARE COMPLETED. EXCESS UNCLASSIFIED EXCAVATION MATERIAL DETERMINED BY THE ENGINEER TO BE SUITABLE FOR BACKFILL SHALL BE USED TO REDUCE ANY UNCLASSIFIED BORROW NEEDED. COSTS OF SECOND HANDLING SHALL BE INCLUDED IN OTHER ITEMS OF WORK. ANY REMAINING EXCESS SPOILS SHALL BECOME THE PROPERTY OF THE CONTRACTOR AND BE DISPOSED OF IN A MANNER APPROVED BY THE ENGINEER.

PRIOR TO FINAL ACCEPTANCE, ALL EXPOSED CURB SURFACES SHALL BE CLEANED OF ALL DISCOLORATION SUCH AS ASPHALT STAINS, TIRE MARKS, OR OTHER DISFIGUREMENT.

ALL FEATURES OF THIS PROJECT INCLUDING, BUT NOT LIMITED TO, PATHS, SIDEWALKS, CURB RAMPS, AND CROSSWALK MARKINGS WILL COMPLY WITH THE PUBLIC RIGHTS—OF—WAY ACCESSIBILITY GUIDELINES (PROWAG), PUBLISHED JULY 26, 2011. WHERE SPECIAL LIMITATIONS OF EXISTING FEATURES WITHIN THE LIMITS OF THE PROJECT PREVENT FULL COMPLIANCE WITH PROWAG, THE CONTRACTOR WILL IMMEDIATELY NOTIFY THE ENGINEER UPON DISCOVERY OF SUCH FEATURES. THE CONTRACTOR WILL NOT PROCEED WITH ANY OF THE WORK, WHICH IS NOT IN FULL COMPLIANCE WITH PROWAG, WITHOUT PRIOR WRITTEN APPROVAL FROM THE ENGINEER. ANY WORK WHICH IS NOT PERFORMED WITHIN THE GUIDELINES OF PROWAG FOR WHICH THE CONTRACTOR DOES NOT HAVE WRITTEN APPROVAL WILL BE CORRECTED AT THE CONTRACTOR'S EXPENSE.

THE CROSS SLOPE FOR PATHS, SIDEWALKS, AND RAMPS WITHIN THE LIMITS OF AN ACCESSIBLE ROUTE WILL NOT EXCEED 1:50 OR 2%.

RAMP LONGITUDINAL SLOPES WILL NOT EXCEED 1:12 OR 8.33%

THE CONTINUOUS PATH'S CROSS SLOPE WILL NOT EXCEED 2% THROUGH DRIVEWAYS. SEE DRIVEWAY DETAIL ON CITY OF NORMAN STANDARD DETAIL ST 16 (RESIDENTIAL DRIVEWAYS), ST 18 (COMMERCIAL DRIVEWAYS AND ALLEYS), AND ST 27.

ALL BASE OR PAVEMENT FAILURES THAT OCCUR AS A RESULT OF EXTENDED EXPOSURE TO INCLEMENT WEATHER SHALL BE REPAIRED AT THE CONTRACTOR'S EXPENSE.

THE CONTRACTOR SHALL AGREE WITH THE CITY INSPECTOR AT THE END OF EACH WORKING DAY ON ALL REMOVAL ITEMS AND CONSTRUCTION ITEMS NOT MEASURABLE AFTER CONSTRUCTION IS COMPLETE.

ALL MATERIALS USED ON THIS PROJECT SHALL BE APPROVED BY THE ENGINEER IN WRITING.

THERE SHALL BE NO PAY ITEM REQUIRED FOR CONTRACTION OR EXPANSION JOINTS. THIS COST SHALL BE INCLUDED IN THE COST OF OTHER ITEMS.

CONTRACTOR SHALL CALL OKIE AT (405) 840-9957 OR 811 PRIOR TO ANY EXCAVATION. IT IS THE CONTRACTOR'S RESPONSIBILITY TO LOCATE AND PRESERVE ALL UTILITIES. THE CONTRACTOR IS RESPONSIBLE FOR CONTACTING ALL UTILITY COMPANIES PRIOR TO CONSTRUCTION. THE CITY OF NORMAN SHALL NOT BE RESPONSIBLE FOR OR PAY FOR ANY DAMAGE CAUSED BY THE CONTRACTOR TO ANY UTILITY ABOVE OR BELOW GROUND.

CONTRACTOR TO ENSURE RESIDENTS MAINTAIN ACCESS TO THEIR PROPERTIES DURING THE CONSTRUCTION PROCESS.

ALL CONSTRUCTION PERFORMED UNDER THIS CONTRACT SHALL BE IN ACCORDANCE WITH THE CITY OF NORMAN STANDARD SPECIFICATIONS AND CONSTRUCTION DRAWINGS AND THE SPECIAL PROVISIONS INCLUDED HEREIN. IN CASE OF CONFLICT BETWEEN STIPULATION OF THE SPECIAL PROVISIONS AND THE STANDARD SPECIFICATION, THE SPECIAL PROVISIONS SHALL TAKE PRECEDENCE AND GOVERN. INTERPRETATION OF THE SPECIFICATIONS SHALL BE MADE BY THE ENGINEER.

THE WORK HEREIN CONTEMPLATED CONSISTS OF FURNISHING ALL TOOLS, LABOR, PLANT EQUIPMENT, MATERIALS AND PERFORMING ALL WORK NECESSARY FOR THE CONSTRUCTION, COMPLETE OF ALL IMPROVEMENTS. IN STRICT ACCORDANCE WITH THESE SPECIFICATIONS.

CONTRACTOR SHALL MAINTAIN A CLEAN AND ORDERLY WORK SITE THROUGHOUT PROJECT AND ENSURE ALL DEBRIS AND POTENTIAL HAZARDS ARE MANAGED APPROPRIATELY.

CONTRACTOR TO ENSURE PROPER DRAINAGE OF THE SITE THROUGHOUT CONSTRUCTION.

CONTRACTOR IS RESPONSIBLE FOR CONSTRUCTION STAKING.

CONTRACTOR SHALL NOTIFY THE CITY A MINIMUM OF 72 HOURS PRIOR TO ANY STREET OR LANE CLOSURE.

CONTRACTOR SHALL MAKE EVERY EFFORT TO PLACE NEW SANITARY AND STORM SEWERS OUTSIDE OF THE TYPICAL PATH OF VEHICLE TIRES.

CONTRACTOR SHALL BE RESPONSIBLE FOR CONTROLLING STORM SEWER FLOW AND SANITARY SEWER FLOW DURING CONSTRUCTION. EQUIPMENT (PUMPS, TEMPORARY PIPING) SHALL BE IN PLACE DURING THE CONSTRUCTION PROCESS AND BEFORE BAIN EVENTS.

GENERAL NOTES (ADD ALTERNATE 1)

REFERENCE ADD ALTERNATE LIMITS

ROADWAY PAY QUANTITY NOTES

- (1) PRICE BID TO INCLUDE COST OF (10-20-10) FERTILIZER, ESTIMATED AT 200 POUNDS PER 1000 S.Y. OF SODDING. PRICE BID TO INCLUDE COST OF (18-46-0) FERTILIZER, ESTIMATED AT 150 POUNDS PER ACRES OF TOPSOIL.
- (2) PRICE BID TO INCLUDED COST OF WATERING, ESTIMATED AT 40 GALLONS PER S.Y.
- (3) TEMPORARY EROSION AND SEDIMENT CONTROL SHALL CONSIST OF TEMPORARY MEASURES WITHIN THE PROJECT LIMITS AND MINIMIZE POLLUTION OF RIVERS STREAMS AND PRIVATE PROPERTIES. SUCH MEASURES MAY INCLUDE BERMS, DIKES, SLOPE DRAINS, BALE BARRIERS, SEDIMENT FILTERS, SEDIMENT BASINS, MULCHES, AND GRASSES. INCLUDES ALL UNPAVED AND DISTURBED AREAS WHICH SHALL RECEIVE SOLID SLAB SOD.
- (4) INCLUDES REMOVAL OF ALL EXISTING ROADWAY DRAINAGE STRUCTURES, MANHOLES, HEADWALLS, PIPE SLEEVES (UNLESS OTHERWISE SPECIFIED), INLETS, FENCES, AND OTHER STRUCTURES WITHIN THE RIGHT—OF—WAY.
- (5) TO BECOME THE PROPERTY OF AND BE DISPOSED OF BY THE CONTRACTOR IN A MANNER APPROVED BY THE ENGINEER.
- (6) ESTABLISHMENT AND RE-ESTABLISHMENT OF HORIZONTAL AND VERTICAL CONTROL, INCLUDING THE SETTING AND RE-SETTING OF BENCHMARKS AND THE STAKING AND RE-STAKING OF RIGHT-OF-WAY, WILL BE INCLUDED IN THE PRICE BID FOR STAKING.
- (7) CONTRACTOR SHALL CONTACT CITY OF NORMAN LINE MAINTENANCE AT (405) 329-0703 PRIOR TO WATER LINE RELOCATION OPERATIONS TO SHUT DOWN WATER MAIN. CONTRACTOR IS NOT ALLOWED TO OPERATE VALVES.
- (8) CONTRACTOR SHALL PROVIDE WRITTEN NOTICE TO HOMEOWNERS TWENTY-FOUR (24) HOURS IN ADVANCE OF WATER MAIN SHUTOFF. NOTICE SHALL INCLUDE APPROXIMATE DURATION. SHUTOFF SHALL OCCUR DURING LOW FLOW TIMES, PREFERABLY MID-DAY, TO MINIMIZE IMPACT TO RESIDENTS.
- (9) PAY ITEM INCLUDE PROVIDING PROPERTY OWNER ACCESS AT ALL TIMES INCLUDING TEMPORARY MATERIAL AS REQUIRED.
- TRAFFIC PAY QUANTITY NOTES
- (10) ALL CONSTRUCTION TRAFFIC CONTROL WILL BE IMPLEMENTED ACCORDING TO CONSTRUCTION PLANS, AND INSTALLED IN A MANNER APPROVED BY THE ENGINEER, IN ACCORDANCE WITH CHAPTER VI OF THE MANUAL ON UNIFORM TRAFFIC CONTROL DEVICES, (CURRENT EDITION), AND COMPLIANT WITH APPLICABLE ODOT STANDARD DRAWINGS. PRICE BID FOR THIS ITEM SHALL BE PAYMENT IN FULL FOR THE INSTALLATION, MAINTENANCE AND SUBSEQUENT REMOVAL OF ALL NECESSARY CONSTRUCTION TRAFFIC CONTROL DEVICES AND PAVEMENT MARKINGS REQUIRED FOR COMPLETION OF THE PROJECT.

ALL SIGNS AND BARRICADES, WHICH ARE SHOWN WITH TYPE "A" LIGHTS IN THE STANDARD DRAWINGS SHALL HAVE THE CORRESPONDING LIGHT ATTACHED DURING NON-DAYLIGHT HOURS.

(11) REMOVAL OF EXISTING SIGNS SHALL INCLUDE THE REMOVAL OF A COMPLETE SIGN ASSEMBLY WHICH MAY INCLUDE MULTIPLE SIGNS, POSTS, FOOTINGS, AND ANY FOOTINGS ADJACENT TO THE SIGN ASSEMBLY. WHEN APPROVED BY THE ENGINEER, FOOTINGS MAY BE OBLITERATED TO A POINT BELOW GROUND LEVEL IN LIEU OF BEING COMPLETELY REMOVED. SEE GENERAL CONSTRUCTION NOTES FOR DISPOSAL OF OLD CONCRETE FOOTING MATERIAL.

DEWATERING PAY QUANTITY NOTES

- (12) DEWATERING SHALL INCLUDE ALL COST ASSOCIATED WITH THE EXCAVATION AND DEWATERING REQUIRE TO CONSTRUCT STORM DRAINAGE PIPES, MANHOLES, SANITARY SEWER PIPES, AND MANHOLES IN THE DRY AND WORKABLE CONDITIONS. ALL WORK SHALL BE DONE IN THE ACCORDANCE TO THE CITY OF NORMAN STANDARD SPECIFICATIONS AND CONSTRUCTION DRAWINGS.
- (13) 3" SURGE ROCK SHALL BE USED FOR THE STABILIZATION AND COMPACTION OF THE GROUND DURING THE DEWATERING OF THE INSTALLATION OF THE PIPES AND MANHOLES.

UTILITY POLE BRACING AND PROTECTION

(14) INSTALLATION OF SANITARY SEWER, STORM SEWER PIPES, MANHOLES, REMOVAL OF PAVEMENT AND CURB AND GUTTER SHALL BE INCLUDED IN THE COST OF COORDINATION WITH OG&E, PLUMB AND / OR BRACING OF UTILITY POLES AND THE PROTECTION OF UTILITY DOWN GUYS DURING CONSTRUCTION. AFTER CONSTRUCTION UTILITIES POLES SHALL BE TO THE ORIGINAL PLUMB BEFORE CONSTRUCTION AS DEEMED BY THE ENGINEER OR OG&E.

STORM SEWER NOTES

(15) ALL ITEMS ASSOCIATED WITH MANHOLES (FRAME, COVER, MASTIC MATERIAL) SHALL BE INCLUDED IN THE COST OF THIS ITEM.

PAVEMENT REPAIR — CONCRETE FOR UTILITY TRENCH

(16) ALL ITEMS ASSOCIATED WITH THE 8" (HES) UTILITY PAVEMENT TRENCH REPAIR (REBAR, PLACEMENT OF REBAR DOWELS, SAW CUT AFTER TRENCH HAS BEEN BACKFILLED AND PORTLAND CEMENT) SHALL BE INCLUDED WITHIN THIS ITEM.

CONCRETE

(17) 3500 PSI @ 28 DAYS — CONCRETE SHALL BE USE AT THE ENGINEER DISCRETION. FOR PROTECTION OF EXISTING EXPOSED PIPE CROSSING.

ADD ALTERNATE 1

(18) 2" MILL AND OVERLAY SHALL BE PERFORM UPON THE COMPLETION AND ACCEPTANCE OF THE STORM DRAIN PIPING INSTALLATION.

63 OKLAHOMA STATUTE ANNOTATED 63§981: ACTIVITY WITHIN SIX FEET OF HIGH VOLTAGE OVERHEAD LINE OR CONDUCTOR PROHIBITED:

NO PERSON, FIRM, CORPORATION OR ASSOCIATION SHALL, INDIVIDUALLY OR THROUGH AN AGENT OR EMPLOYEE AND NO PERSON AS AN AGENT OR EMPLOYEE OF ANY PERSON, FIRM, CORPORATION OR ASSOCIATION, SHALL PERFORM OR PERMIT ANY AGENT OR EMPLOYEE TO PERFORM ANY FUNCTION OR ACTIVITY UPON ANY LAND, BUILDING, HIGHWAY, OR OTHER PREMISES, WHEN IT IS POSSIBLE DURING THE PERFORMANCE OF SUCH ACTIVITY FOR ANY PERSON OR EMPLOYEE ENGAGED IN PERFORMING WORK CONNECTED WITH OR RELATED TO SUCH FUNCTION OR ACTIVITY TO MOVE TO OR TO BE PLACED IN A POSITION WITHIN SIX (6) FEET OF ANY HIGH VOLTAGE OVERHEAD ELECTRICAL LINE OR CONDUCTOR, OR WHEN IT IS POSSIBLE FOR ANY PART OF ANY TOOL, EQUIPMENT, MACHINERY OR MATERIAL TO BE USED BY ANY SUCH PERSON OR EMPLOYEE TO BE BROUGHT WITHIN SIX (6) FEET OF ANY SUCH OVERHEAD HIGH VOLTAGE LINE OR CONDUCTOR THROUGH ANY LATERAL, VERTICAL OR SWINGING MOTION DURING THE PERFORMANCE OF SUCH FUNCTION OR ACTIVITY.



CERTIFICATE OF AUTHORIZATION: CA 973 (PE/LS) EXPIRES 6/30/2026

W. BOYD STREET STORM SEWER REPLACEMENT

FROM S. PICKARD AVE TO COLLEGE AVE. CITY OF NORMAN, OK

Key Plo

Νo.		Desc	cription			Date
7	EDITED	NOTES	AND	PAY	ITEMS	11-15-24

This document, and the ideas and designs incorporated herein, as an instrument of professional service, is the property of Crafton, Tull & Associates, Inc., and is not to be used, in whole or in part, for any other project, without the written authorization of Crafton, Tull & Associates, Inc.

PROJECT NO: 23606900 ISSUE DATE: 11/4/2024

ISSUE DATE: 11/4/2024

CONTACT: M.WILLIAMS

QC by: M.LOVE

QC Date:


ISSUED FOR CONSTRUCTION

© 2024 Crafton, Tull & Associates, Inc.


QUANTITIES & GENERAL NOTES


C-101

30" STORM SEWER REPLACEMENT

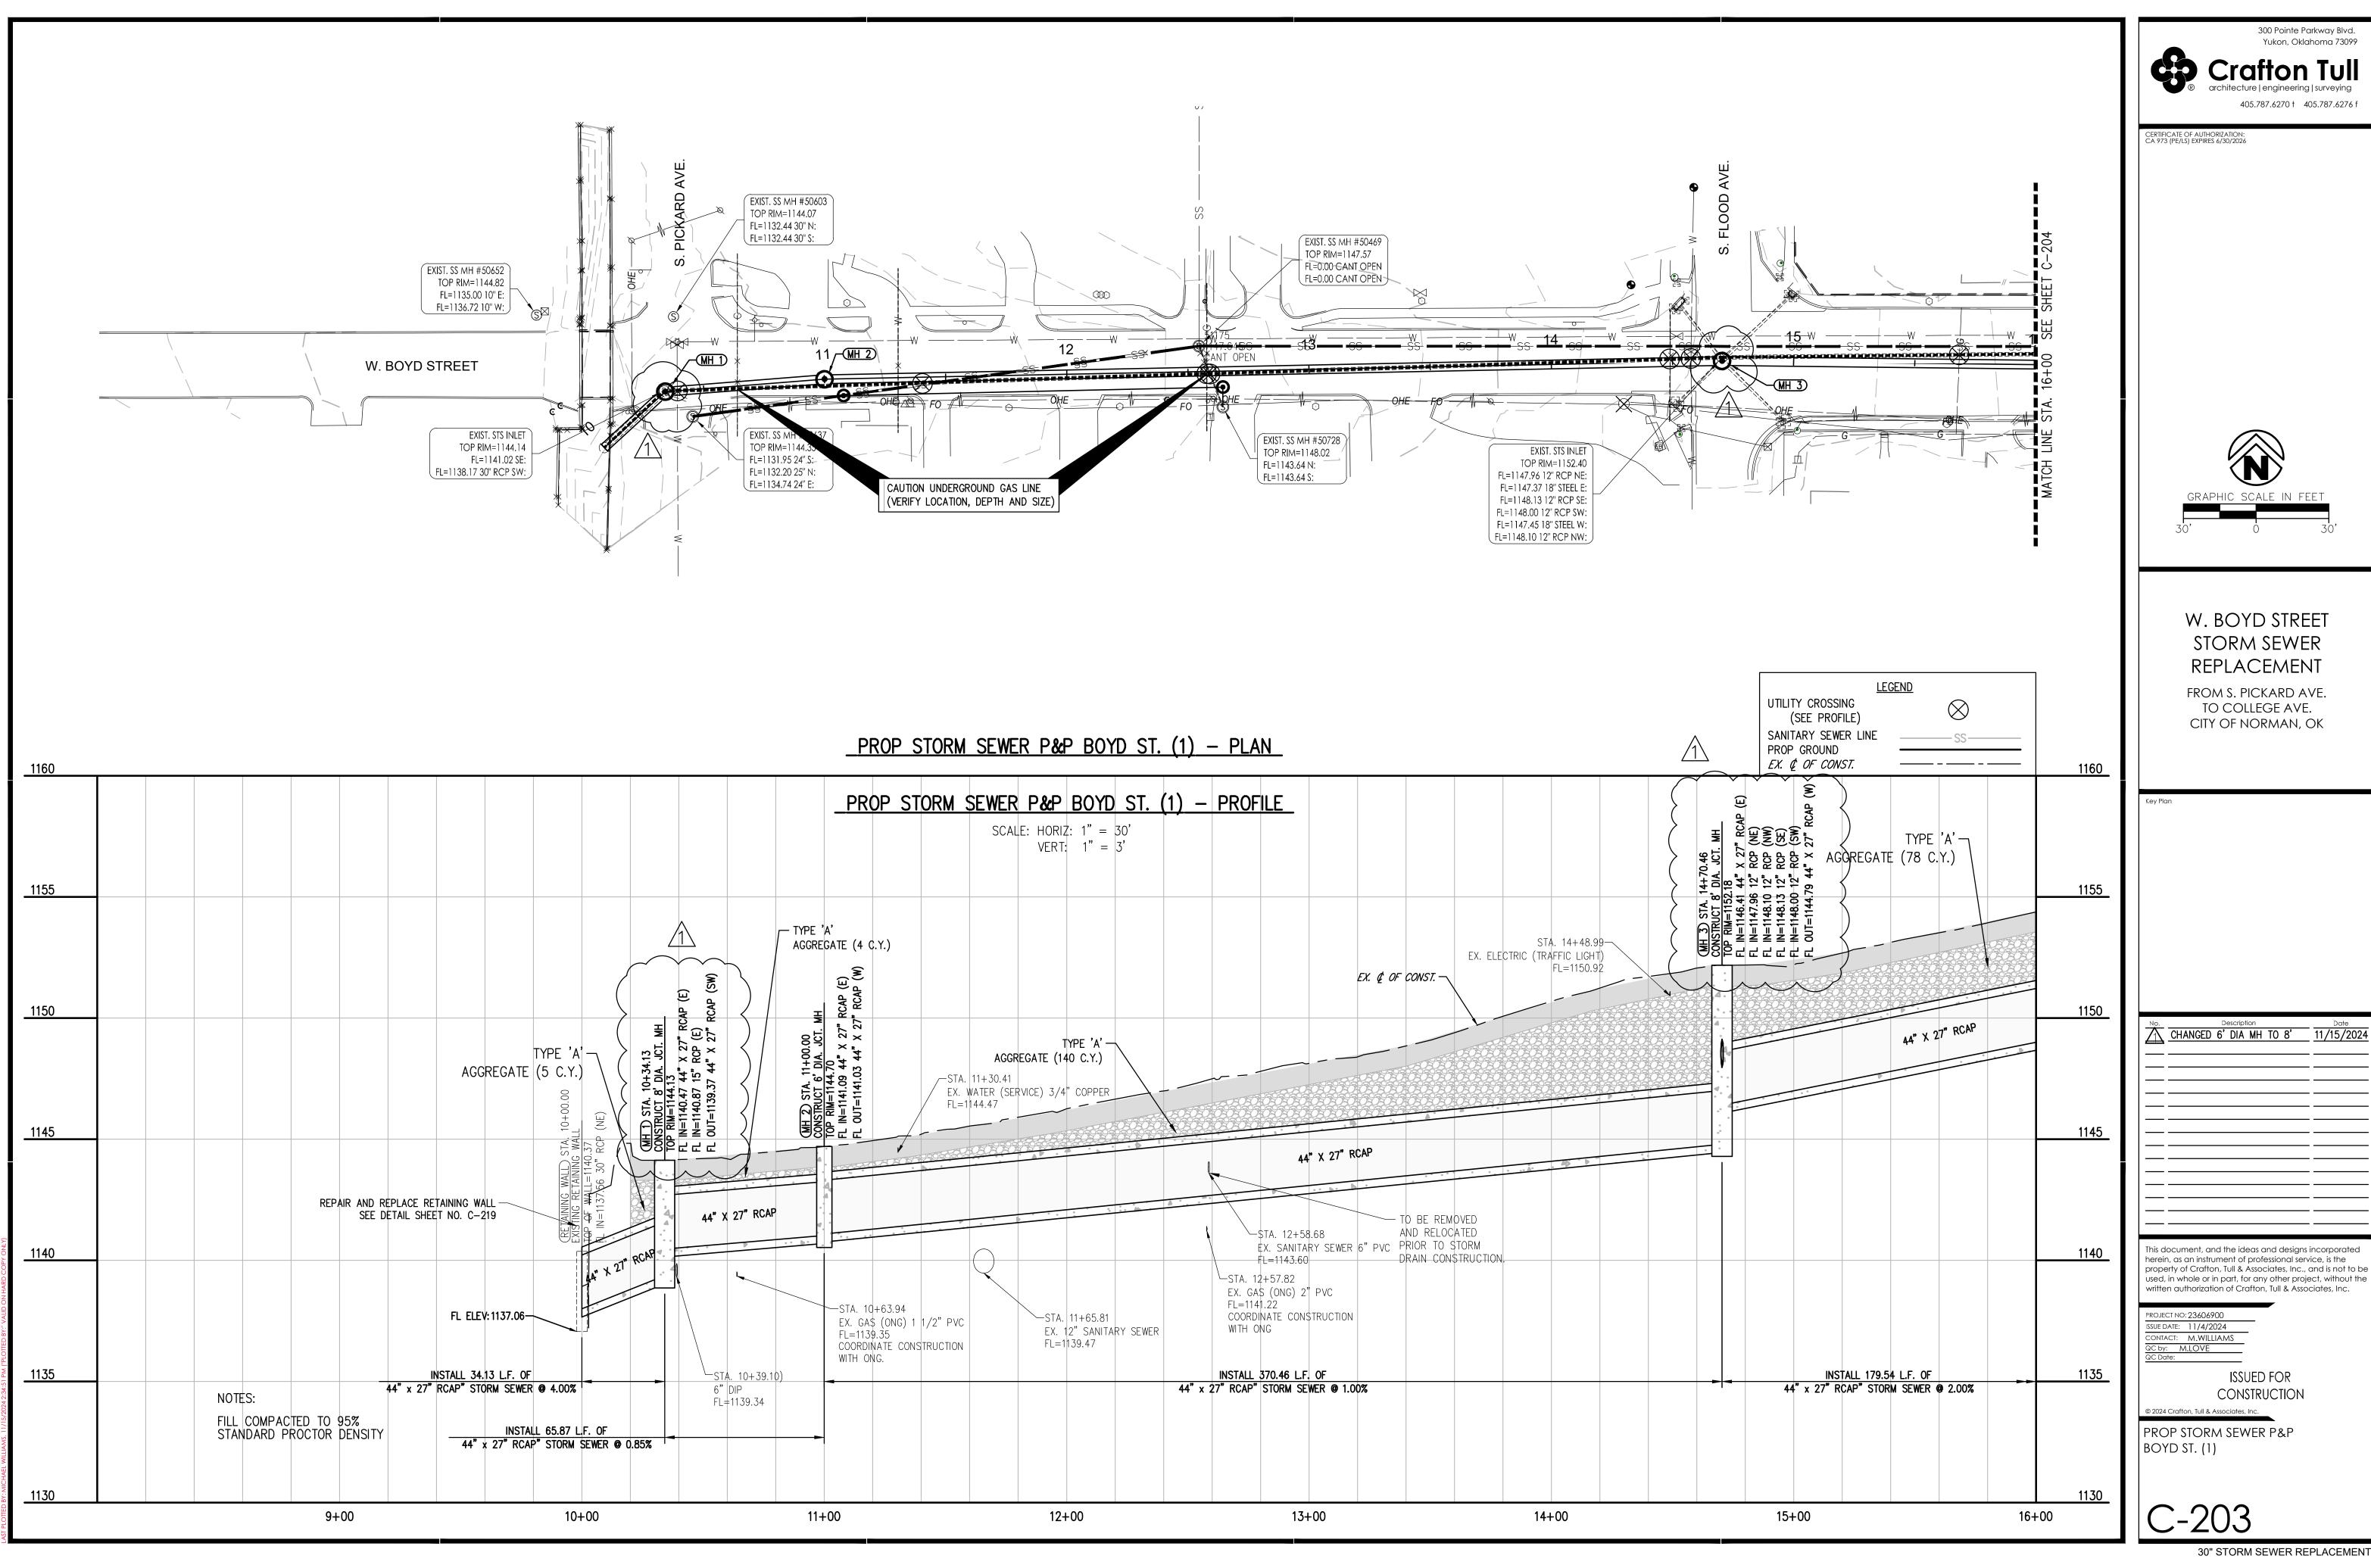


30" STORM SEWER REPLACEMENT

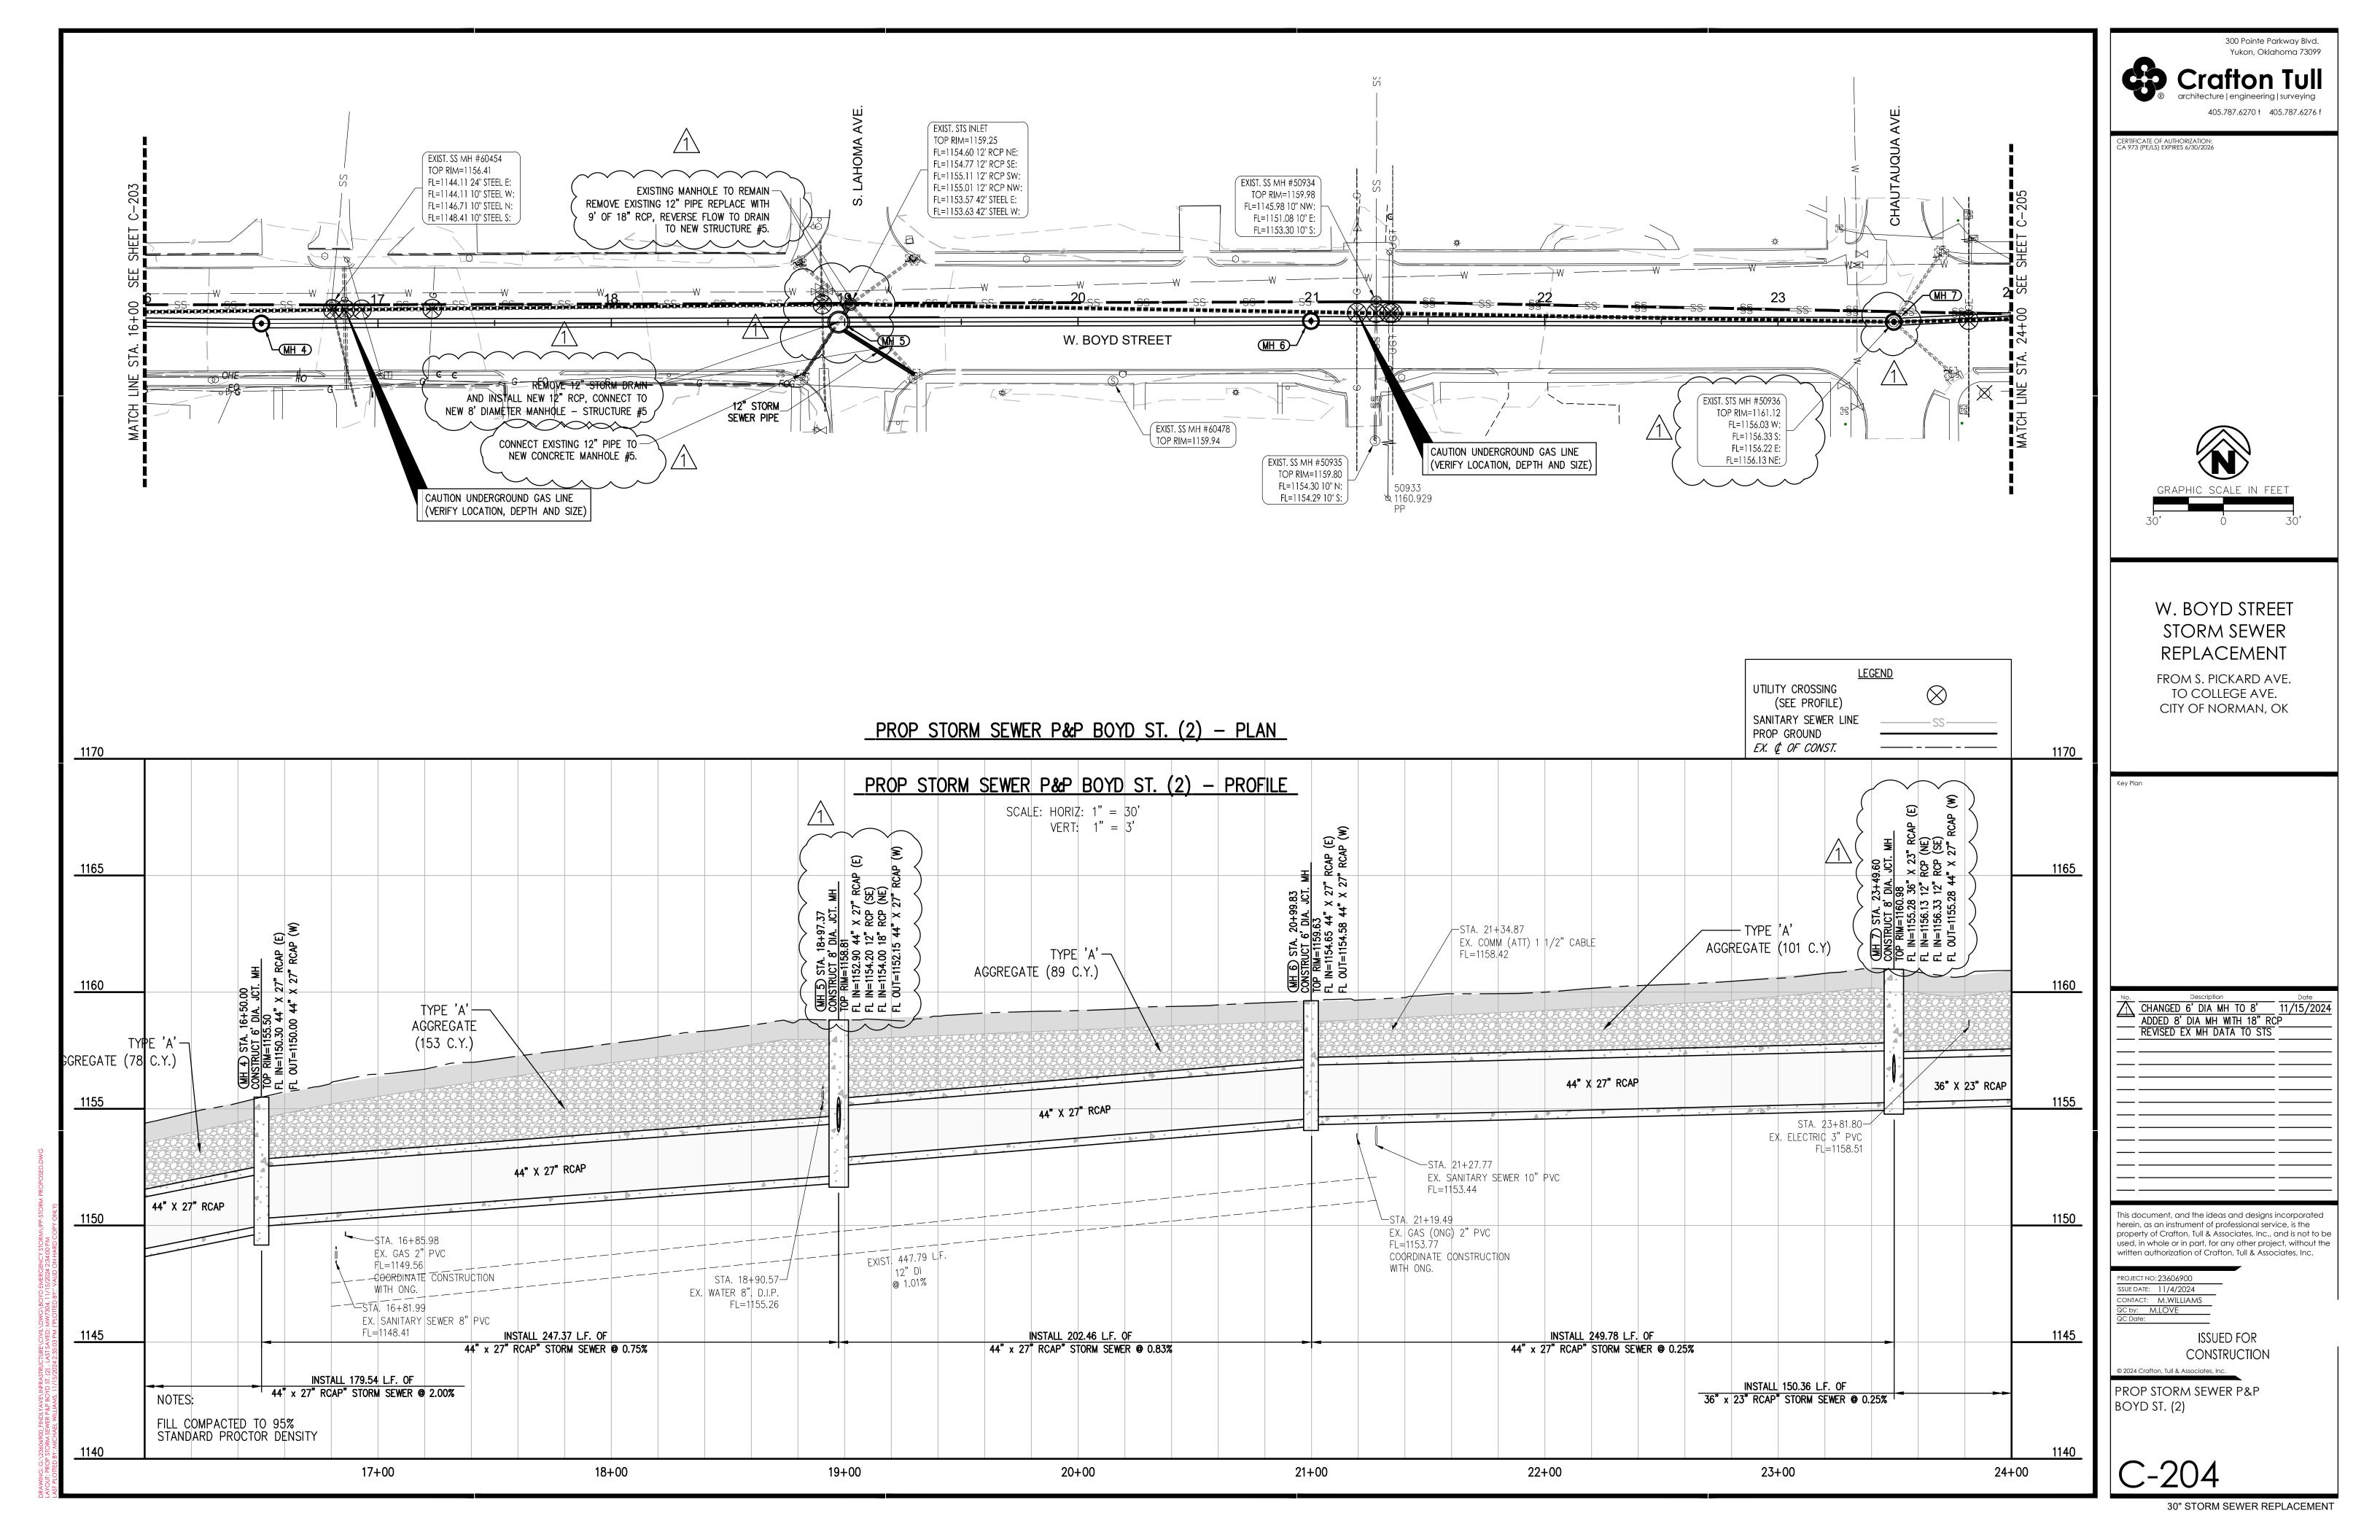

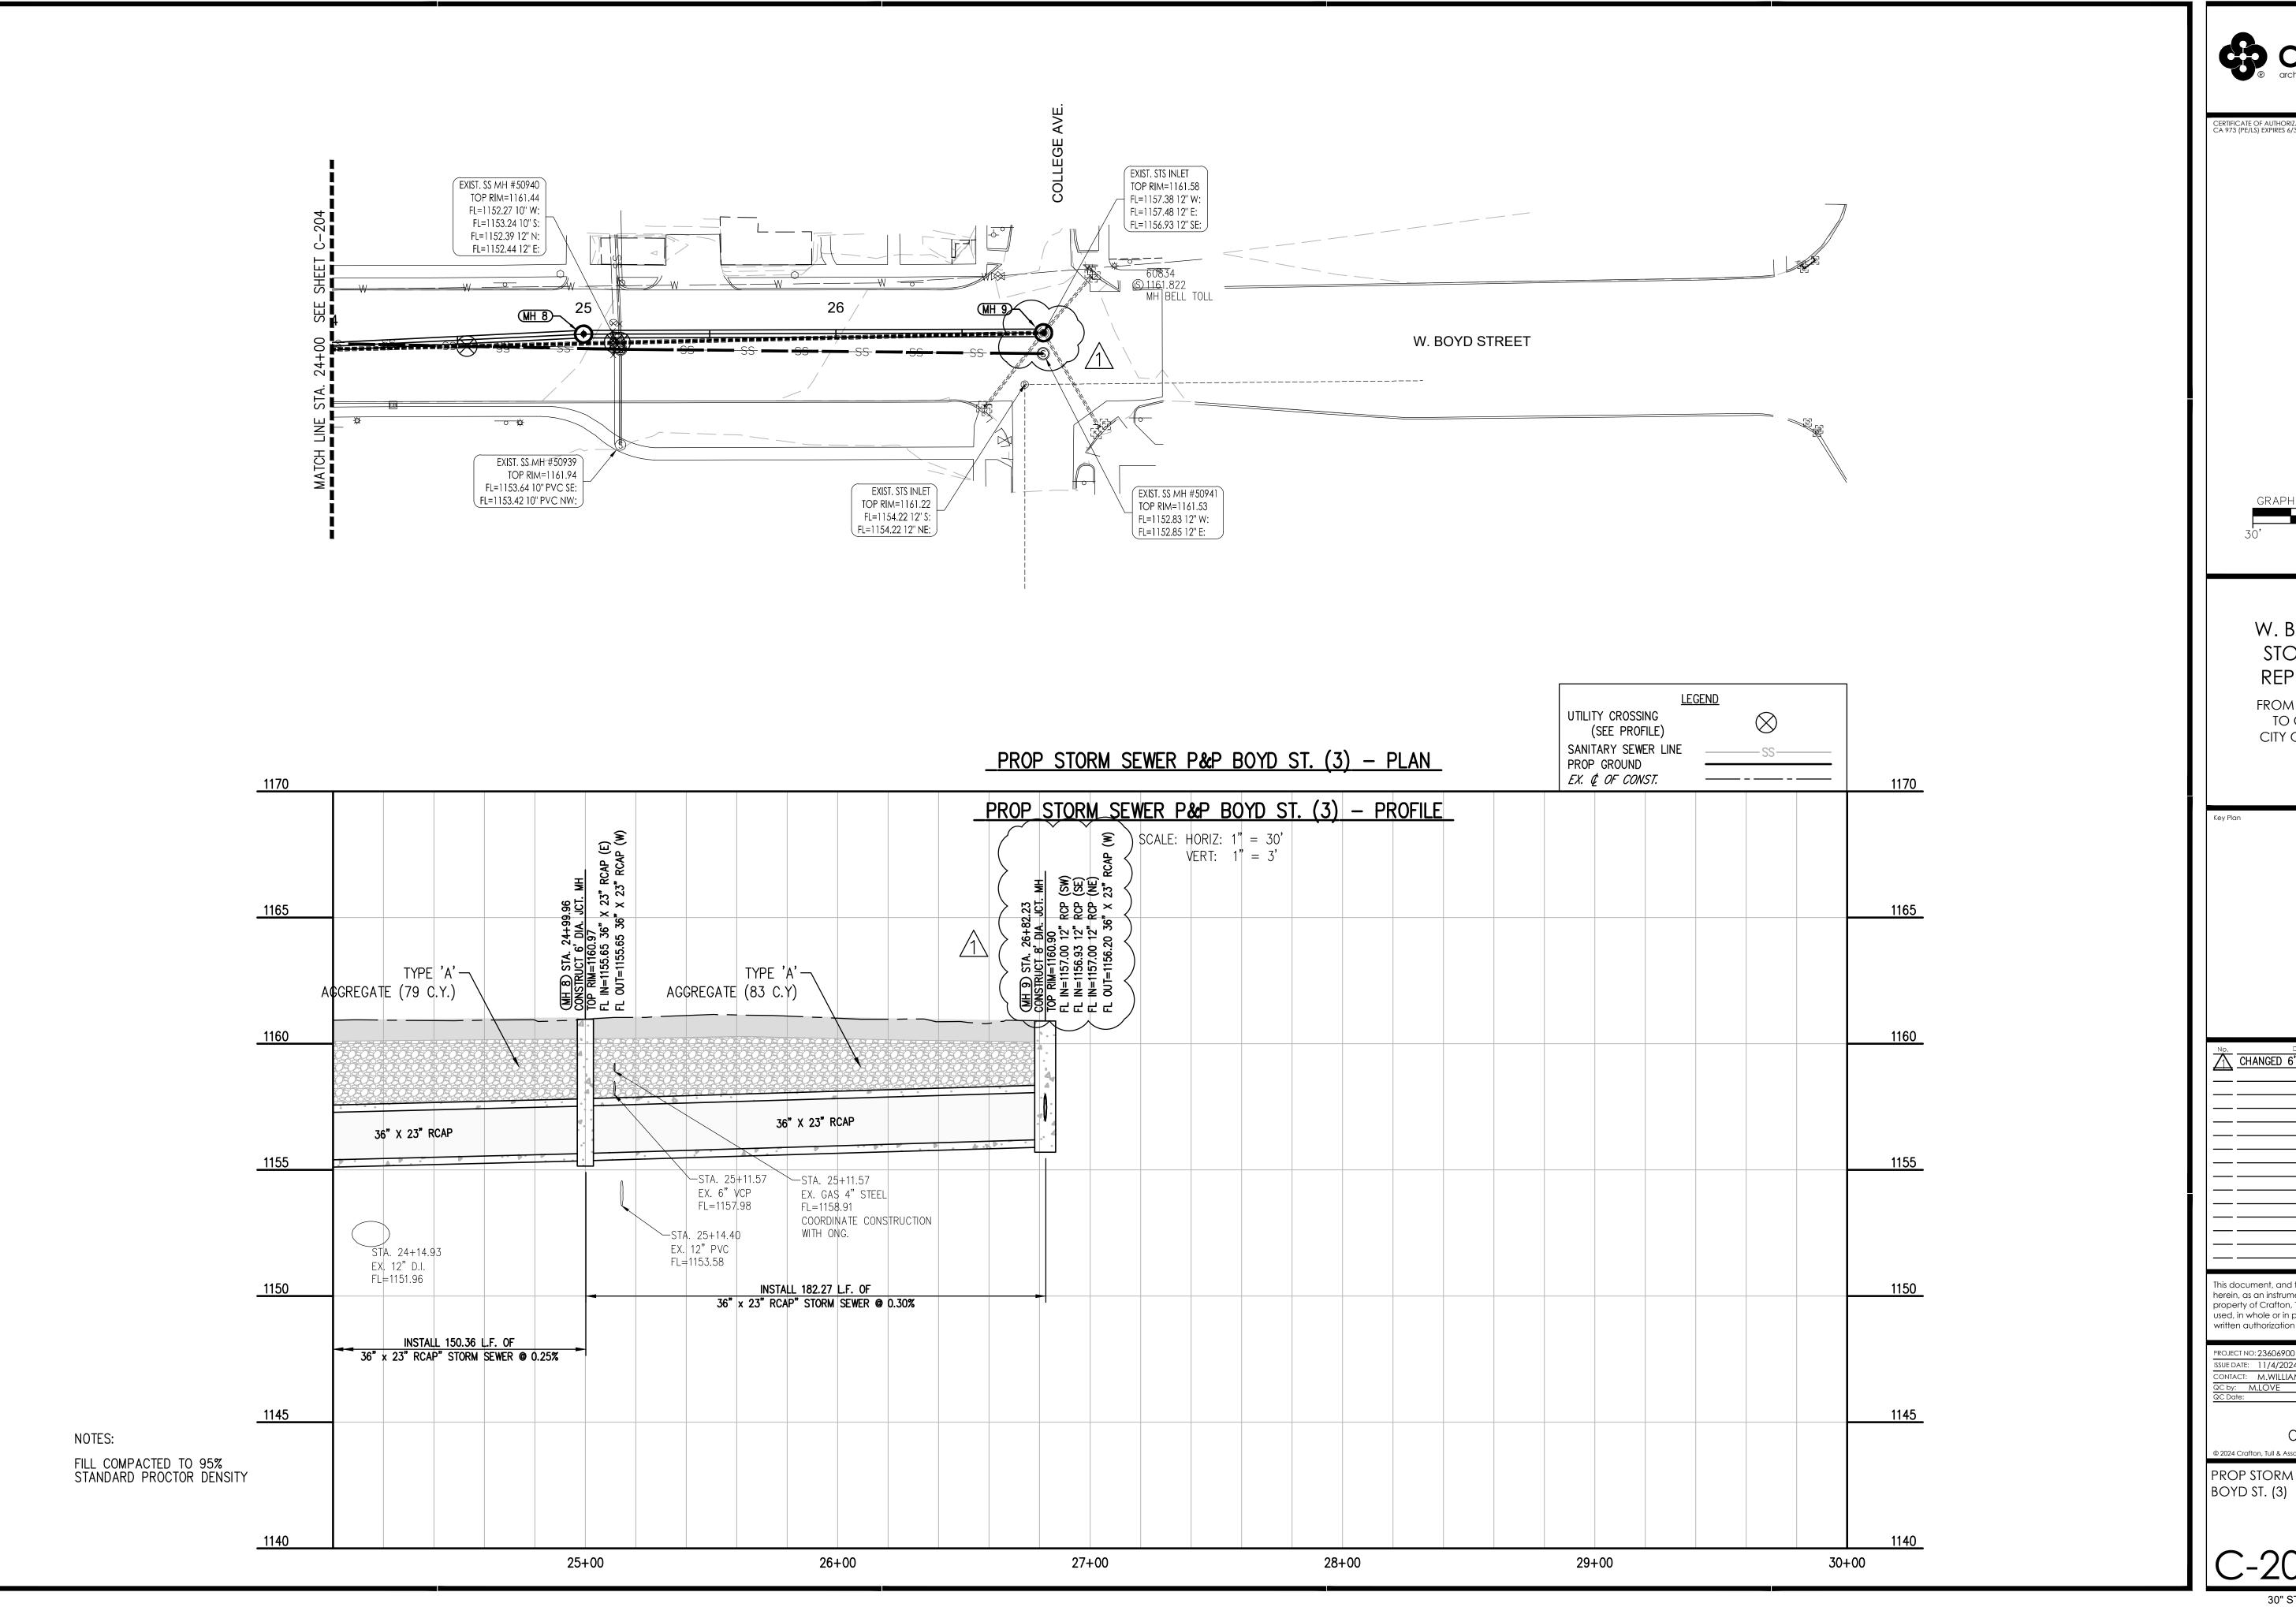



CERTIFICATE OF AUTHORIZATION: CA 973 (PE/LS) EXPIRES 6/30/2026

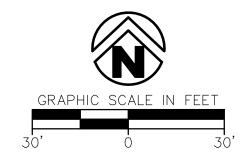

W. BOYD STREET STORM SEWER REPLACEMENT

FROM S. PICKARD AVE. TO COLLEGE AVE. CITY OF NORMAN, OK

No.	Description	Date
$\overline{\Lambda}$	CHANGED 6' DIA MH TO 8'	11/15/2024

This document, and the ideas and designs incorporated herein, as an instrument of professional service, is the property of Crafton, Tull & Associates, Inc., and is not to be used, in whole or in part, for any other project, without the written authorization of Crafton, Tull & Associates, Inc.

PROJECT NO: 23606900 ISSUE DATE: 11/4/2024 CONTACT: M.WILLIAMS

QC by: M.LOVE

QC Date:

> **ISSUED FOR** CONSTRUCTION

© 2024 Crafton, Tull & Associates, Inc. PROP STORM SEWER P&P